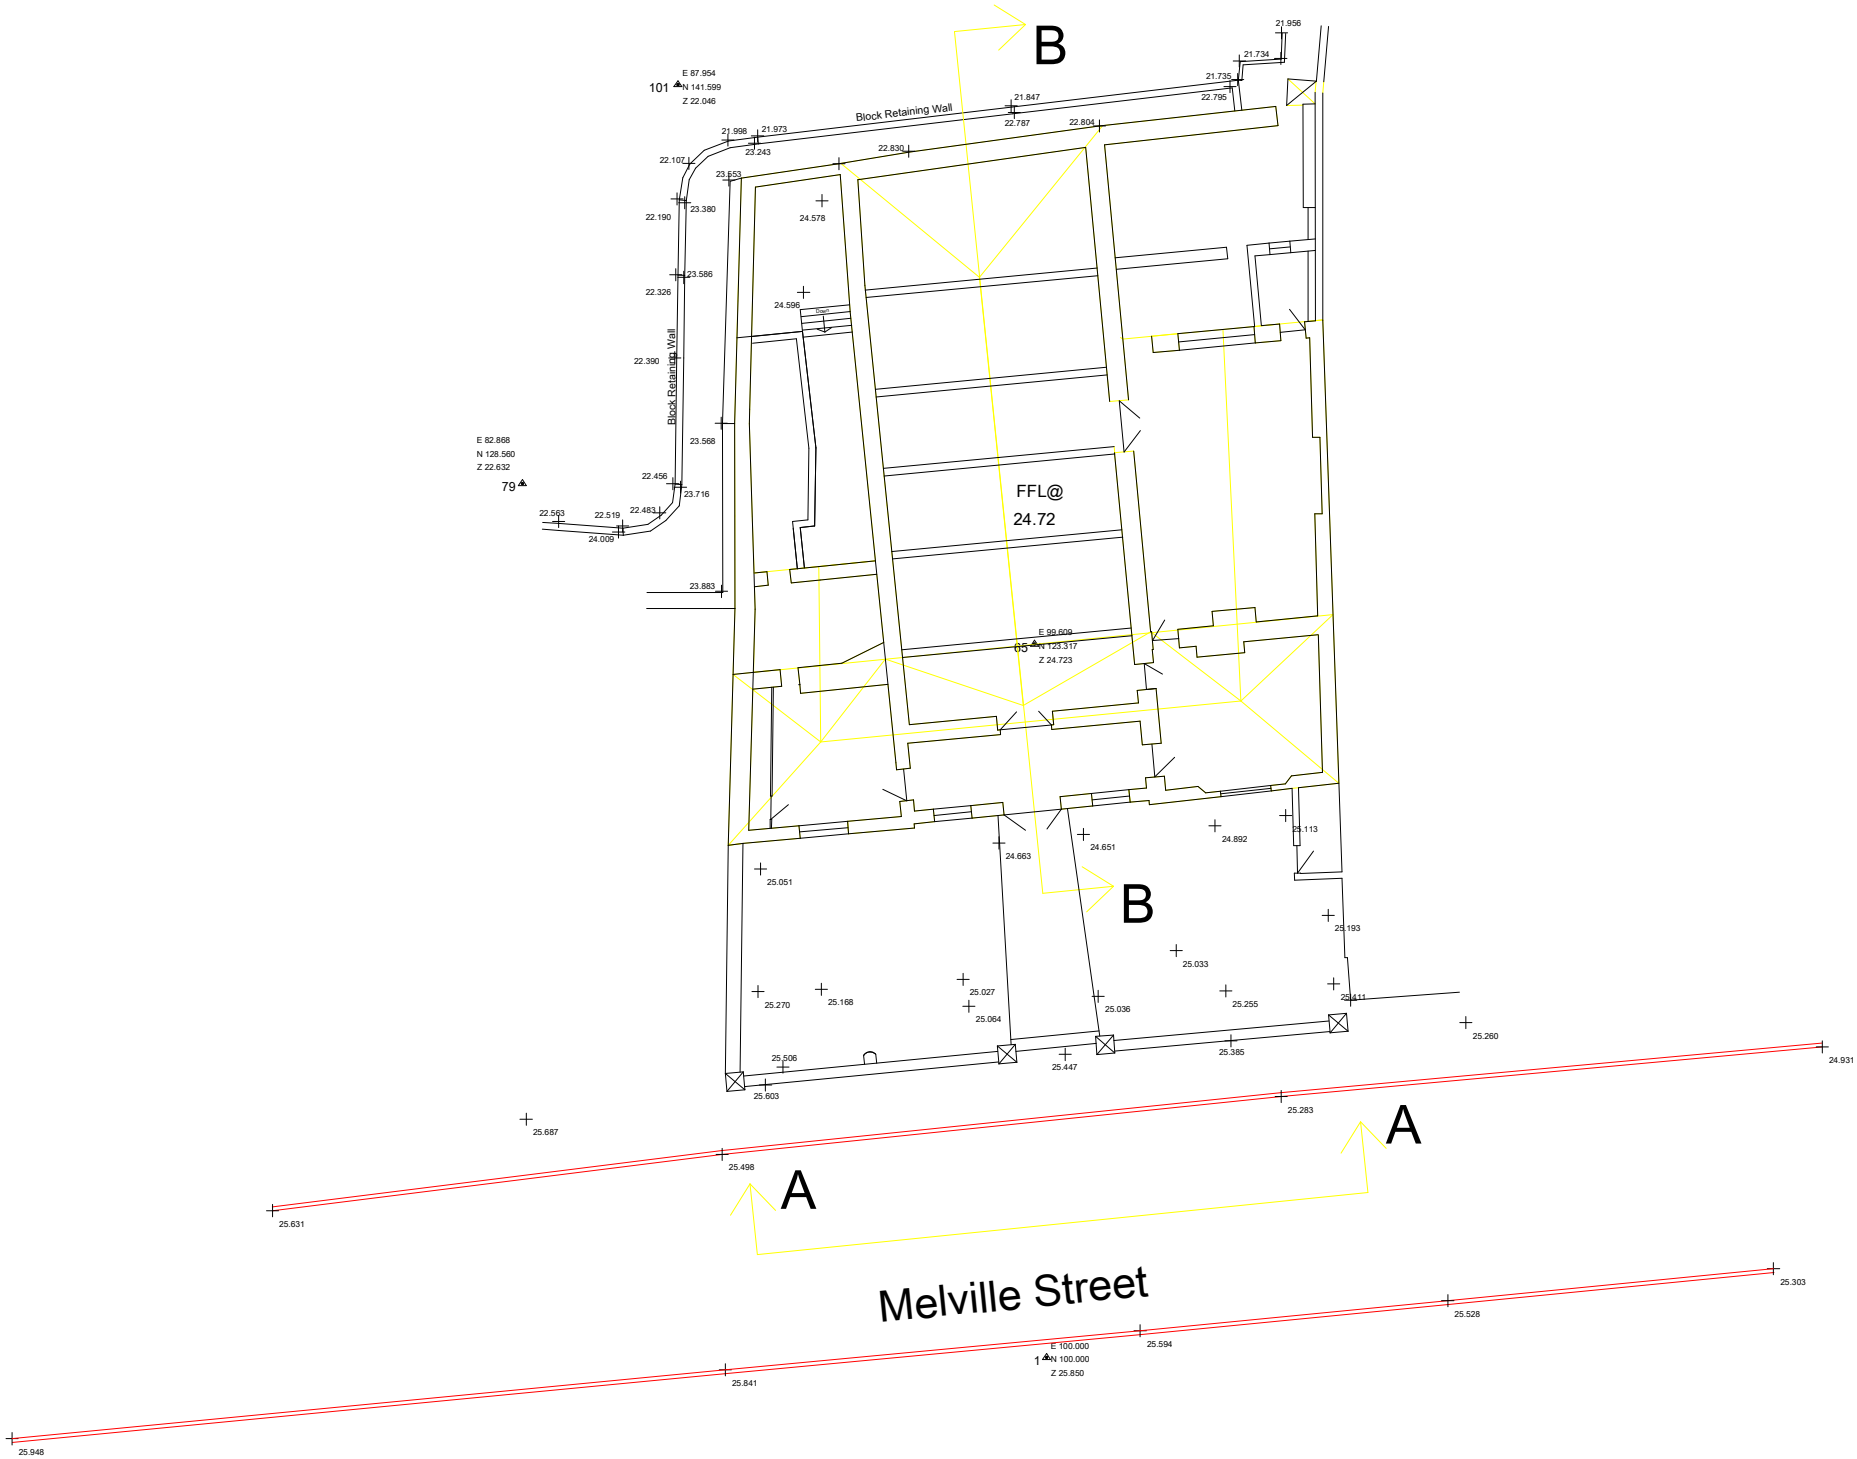
B
B
A
A
Melville Street
Block Retaining Wall
Block Retaining Wall
FFL@
24.72
101
E 87.954
N 141.599
Z 22.046
79
E 82.868
N 128.560
Z 22.632
65
E 99.609
N 123.317
Z 24.723
1
E 100.000
N 100.000
Z 25.850
21.956
21.734
21.735
22.795
21.847
22.787
22.804
21.998
21.973
23.243
22.830
22.107
23.653
22.190
23.380
24.578
22.326
23.586
24.596
22.390
23.568
22.456
23.716
22.563
22.519
22.483
24.009
23.883
24.663
24.651
24.892
25.113
25.051
25.193
25.033
25.270
25.168
25.027
25.064
25.036
25.255
25.411
25.260
25.506
25.447
25.385
24.931
25.603
25.283
25.687
25.498
25.631
25.303
25.528
25.594
25.841
25.948